


RETAIL TOTAL = 4,911 SF
(BOMA RETAIL METHOD)


1,537 SF

1,030 SF

2,344 SF

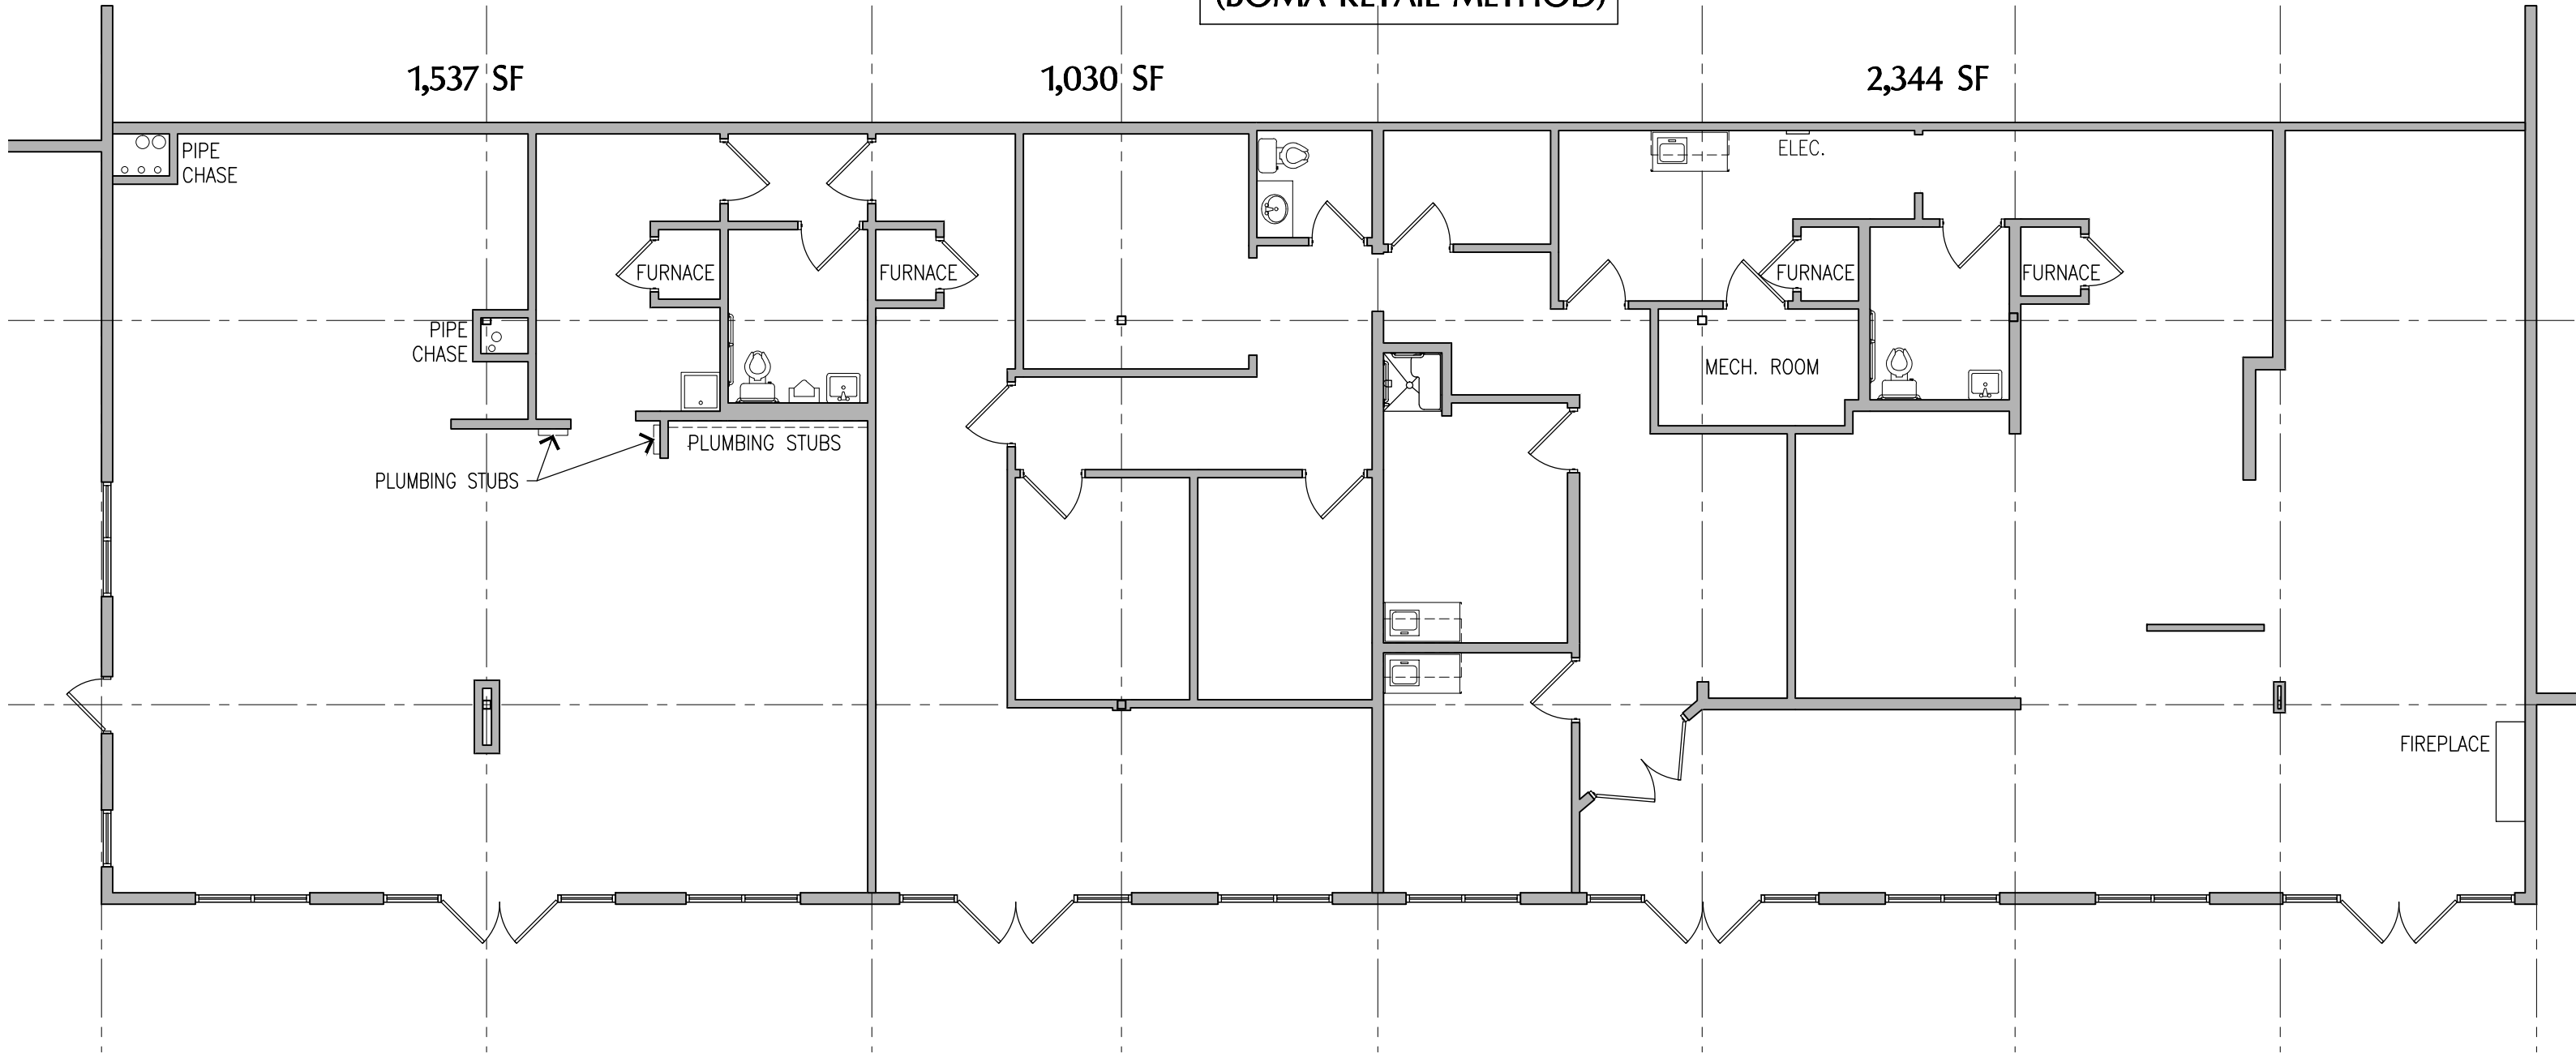

LEXINGTON SHORES - EXISTING RETAIL FLOOR PLAN

SCALE: 1/8" = 1'-0" 

SHOREVIEW, MINNESOTA
May 8, 2012